

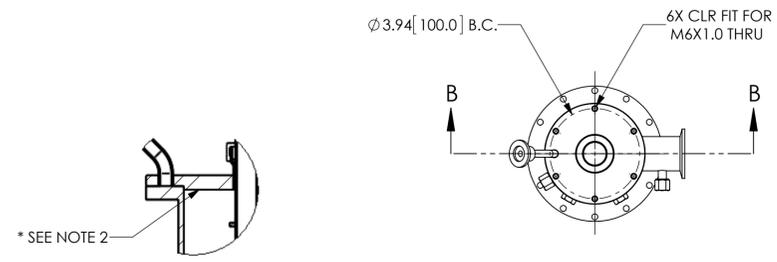


GENERAL NOTES:


- 1. ALL MODELED PARTS OUTSIDE THE VTI ARE FOR VISUAL REPRESENTATION ONLY. DO NOT USE FOR FABRICATION.
- 2. MEASUREMENTS TAKEN FROM THIS SURFACE ARE INDICATED WITH \*.

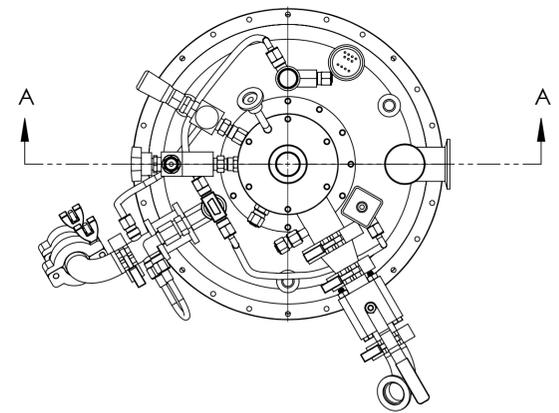


DETAIL D  
SCALE 1:2

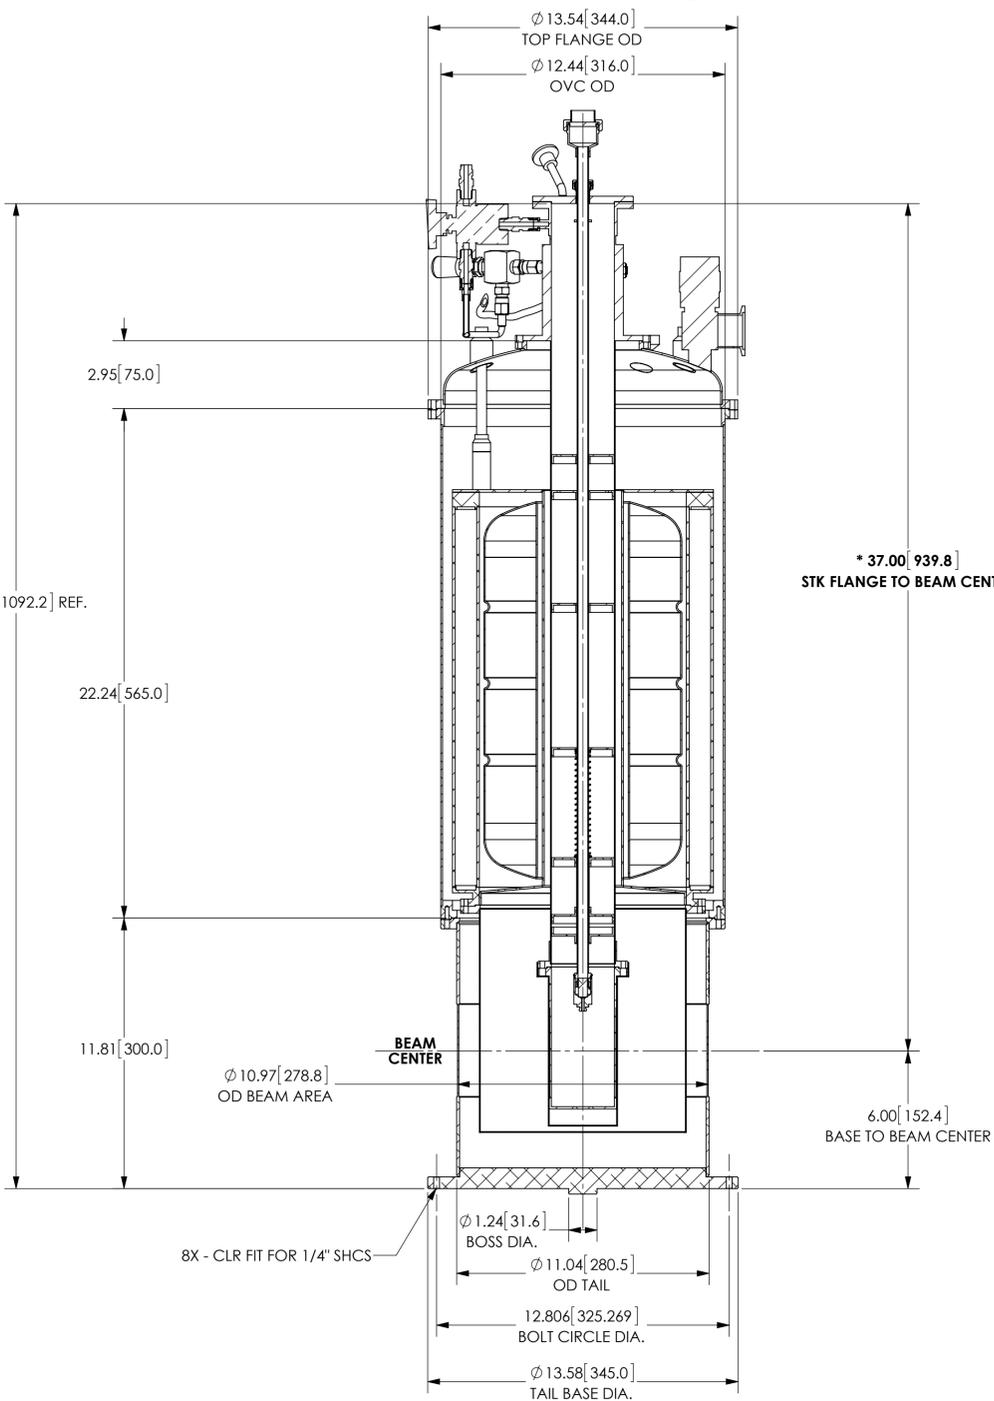

CRYO-D  
SECTION A-A  
SCALE: 1:4

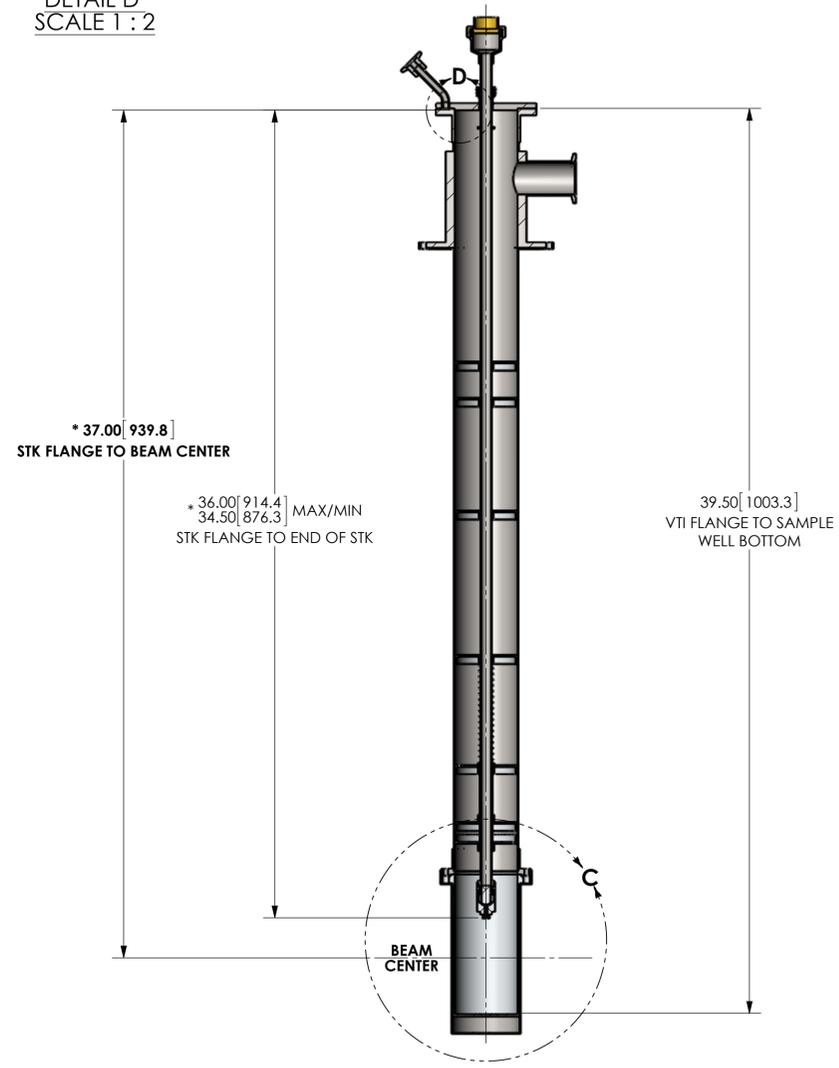

SECTION B-B  
CRYO D - VTI  
SCALE: 1:4

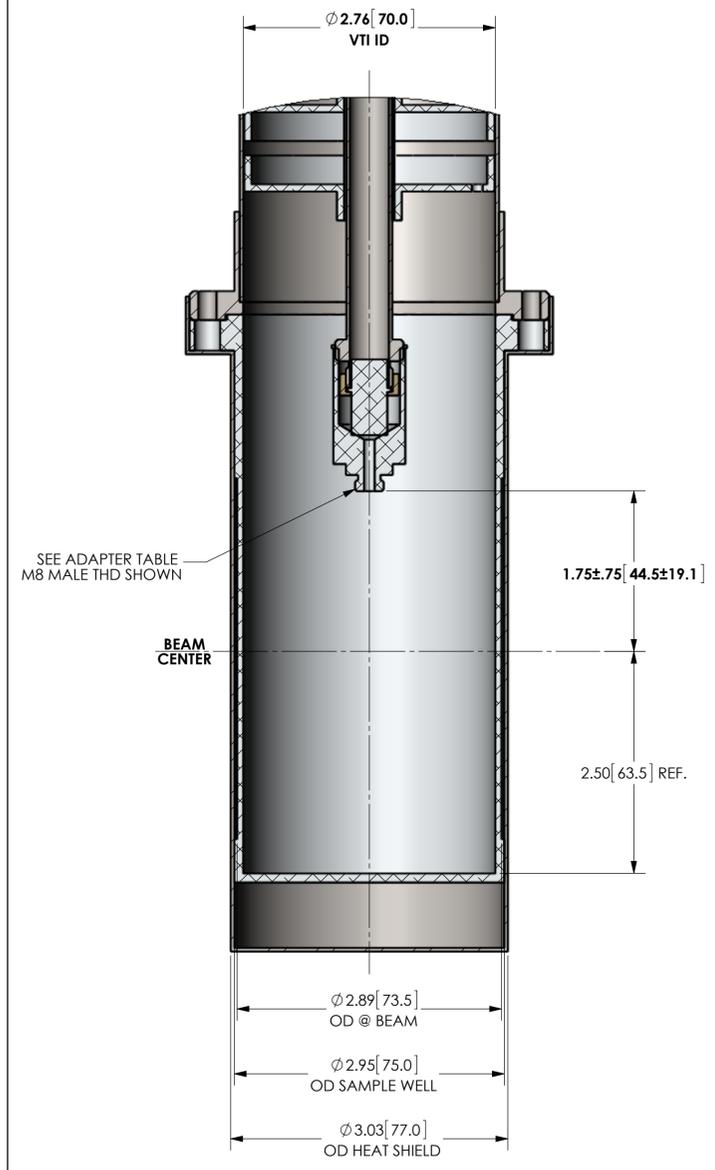

SAMPLE AREA  
DETAIL C  
SCALE 1:1

ADAPTER TABLE	
SIZE	INTERFACE
1/4 POST	FEMALE
1/4-28 UNF	FEMALE
5/16-18 UNC	MALE OR FEMALE
M6-1.0	FEMALE
M8X1.25	MALE OR FEMALE

REVISION  
AS BUILT

**CAUTION NUCLEAR EQUIPMENT:**  
 ANY PROCESS OR MATERIAL (INCLUDING PACKAGING AND SHIPPING MATERIALS) THAT HAS THE POSSIBILITY OF LEAVING A RESIDUE CONTAINING ANY OF THE HAZARDOUS ELEMENTS (PRIMARILY CHLORINE AND FLUORINE), METALLIC ELEMENTS (PRIMARILY COPPER, LEAD, NICKEL, SILVER, THORIUM, AND URANIUM) OR CARBON/GRAPHITE ON THE SURFACE OF ANY HERE COMPONENT AFTER FINAL CLEANING SHALL NOT BE USED. MERCURY IN ANY FORM SHALL BE SPECIFICALLY PRECLUDED IN THE PROCUREMENT OF ALUMINUM RAW MATERIALS AND IN ALL PROCESSING AND MANUFACTURING OPERATIONS.  
 NO REPRESENTATION OR WARRANTY, EXPRESSED OR IMPLIED, IS MADE THAT THE USE OR DISCLOSURE OF ANY INFORMATION, APPARATUS, METHOD OR PROCESS DISCLOSED IN THIS DRAWING MAY NOT INFRINGE PRIVATE RIGHTS OF OTHERS. NO LIABILITY IS ASSUMED WITH RESPECT TO THE USE OF, OR FOR DAMAGES RESULTING FROM THE USE OF, ANY INFORMATION, APPARATUS, METHOD OR PROCESS DISCLOSED IN THIS DRAWING. THIS DRAWING IS BEING MADE AVAILABLE FOR INFORMATION TO THE READER AND IS NOT TO BE USED FOR OTHER PURPOSES, AND IS TO BE RETURNED UPON REQUEST TO THE FORWARDING CONTRACTOR.

GENERAL SPECIFICATIONS	
UNLESS OTHERWISE SPECIFIED	
DIMENSIONS ARE IN INCHES	
REMOVE BURRS/BREAK EDGES	
FRACTIONS ±	N/A
xx DECIMALS ±	N/A
xxx DECIMALS ±	N/A
ANGLES ±	N/A
FILLET	N/A MAX.
MACHINE FINISH	N/A MAX.
SCALE:	XX=XX

NO.	REVISIONS			
	DESIGNER	DATE	SAFETY ANALYST	DATE
	B.S. BACH			
	TASK LEADER	DATE	Q.A. SPECIALIST	DATE
	DESIGN REVIEWER	DATE	CFG. CONTROL MGR	DATE
			APPROVED	DATE
			MAINT MGR	DATE
			OPERATIONS MGR	DATE

REFERENCE DRAWINGS	NUMBER
 OAK RIDGE NATIONAL LABORATORY RESEARCH REACTORS DIVISION operated for the DEPARTMENT OF ENERGY under the GOVERNMENT of the United States of America	
FACILITY <b>SNS</b>	BLDG. NO. <b>8700</b>
<b>CRYO - 008 USER INFORMATION</b>	
D	REV.